



SALE PLAN

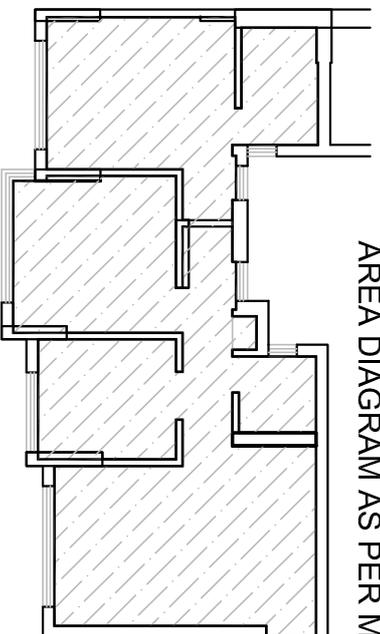

AREA DIAGRAM AS PER MOFA

AREA 57.41 Sq.M.
= 618 Sq.Ft.

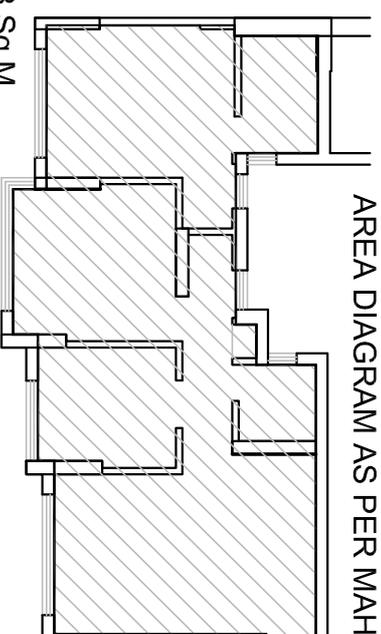

AREA DIAGRAM AS PER MAHARERA

AREA 59.78 Sq.M.
= 644 Sq.Ft.

DATE : 19th Feb,2021

AS BUILT PLAN OF APARTMENT - [REDACTED]
AT GHATKOPAR MUMBAI

[REDACTED] [REDACTED]
GHATKOPAR, MUUMBAI

AS BUILT AREA STATEMENT

LIVING ROOM	17.69	SQ.M.
KITCHEN	6.62	SQ.M.
BED ROOM 1	10.06	SQ.M.
COMMON TOILET	2.4	SQ.M.
PASSAGE	4.77	SQ.M.
M. BED ROOM	12.27	SQ.M.
TOILET	3.6	SQ.M.
TOTAL CARPET AREA	57.41	SQ.M.
	618	SQ.FT.
MAHARERA CARPET AREA	59.78	SQ.M.
	644	SQ.FT.

NOTE :

THE MOFA CARPET AREA GIVEN IS INCLUDING AREA UNDER COLUMNS PROJECTING IN THE INTERIOR SPACES

